

Nine figure	327200530	Status	OK	Type	SCN (GDA), Est. AHD
Easting	372133.210	Northing	5787610.478	AHD height	57 Zone 55
Latitude	-38° 03' 00.7935"	Longitude	145° 32' 33.5682"	Ellipsoid height	62 CSF 0.9997924
H _z uncertainty	0.042	H _z order	4	V _t uncertainty	V _t order 5
Plan ref		Datum	GDA2020		


SEC. 6 (1) (c) SURVEY CO-ORDINATION ACT 1958

PERMANENT MARK SKETCH PLAN

Township _____ Parish Nar Nar Goon

- NOTE:— Not necessarily to Scale
- (1) Measurements to be shown from the Permanent Mark to as many near-by survey marks, buildings, fence posts, hydrants, trees, &c., as practicable. Up to six such measurements are desirable.
 - (2) Except where verified by a Licenced Surveyor in this survey, all boundaries in this sketch plan are to be shown by broken lines. The symbols for fences, buildings, &c., to be shown on the broken lines.
 - (3) Description of Permanent Mark and, where possible, Crown Abuttals are to be shown.

MEASUREMENTS ARE IN feet

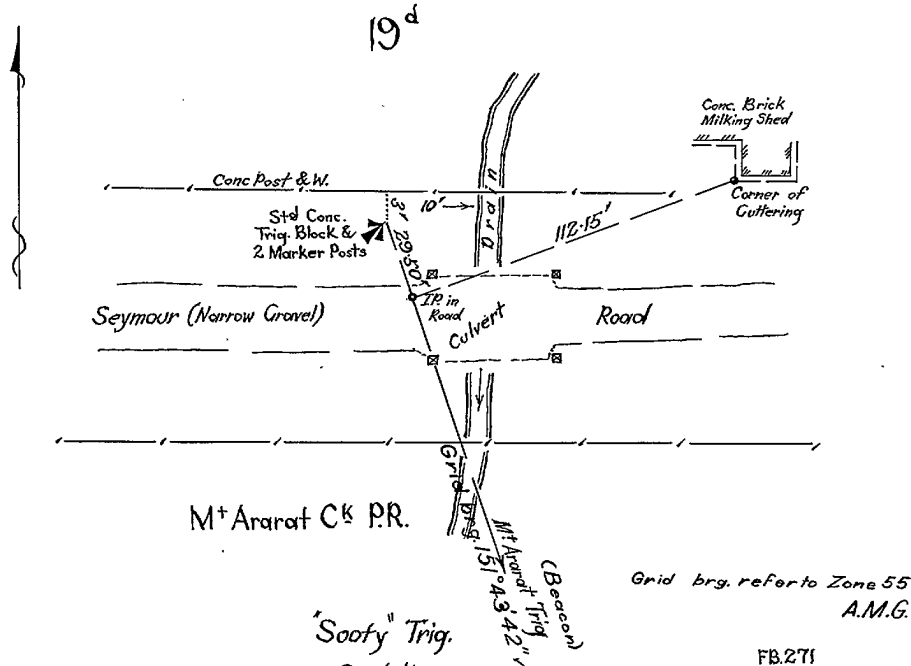

Established in connection with* Geodetic Ref. No. FB.271 69-207
 *Type of Survey of Works

IF LEVELLED:—
 Reduced level of Mark _____ to Datum † _____
 †e.g., Railways, Board of Works, Sewerage Authority, &c., or Arbitrary.

I certify that the Permanent Marks shown in this sketch have been established on the ground by me in accordance with the Regulations under the Survey Co-ordination Act 1958 and that the information shown hereon is correct.

Department or Authority Crown Lands & Survey Signature R.M. L.S. †
 Date 14.7.69

† If a Licensed Surveyor the letters L.S. to be added
 TO BE FILLED IN BY THE CENTRAL PLAN OFFICE

Zone	Square	Subdivision	Same Datum R.L.	Number
			R.L. Copied from	53

Noted on Record Plan N 11 (6) RB 28/10/69 "SOOTY" TRIG.
 3937/67

T.O. Shire of Berwick S.R. & W.S.C.

17 JUL 1969