


|                            |                   |                      |                   |                            |                        |
|----------------------------|-------------------|----------------------|-------------------|----------------------------|------------------------|
| Nine figure                | 225500070         | Status               | OK                | Type                       | SCN (GDA), Est. AHD    |
| Easting                    | 466754.867        | Northing             | 5745738.855       | AHD height                 | 624.6 Zone 55          |
| Latitude                   | -38° 26' 09.6168" | Longitude            | 146° 37' 08.6760" | Ellipsoid height           | 629.4 CSF 0.9995157    |
| H <sub>z</sub> uncertainty | 0.032             | H <sub>z</sub> order | 3                 | V <sub>t</sub> uncertainty | V <sub>t</sub> order 5 |
| Plan ref                   |                   | Datum                | GDA2020           |                            |                        |

SEC. 6 (1) (c) SURVEY CO-ORDINATION ACT 1958  
**PERMANENT MARK SKETCH PLAN**

3

Township..... Parish BULGA

- NOTE:— Not necessarily to Scale
- (1) Measurements to be shown from the Permanent Mark to as many near-by survey marks, buildings, fence posts, hydrants, trees, etc., as practicable. Up to six such measurements are desirable.
  - (2) Except where verified by a Licensed Surveyor in this survey, all boundaries in this sketch plan are to be shown by broken lines. The symbols for fences, buildings, etc., to be shown on the broken lines.
  - (3) Description of Permanent Mark and, where possible, Crown Abuttals are to be shown.

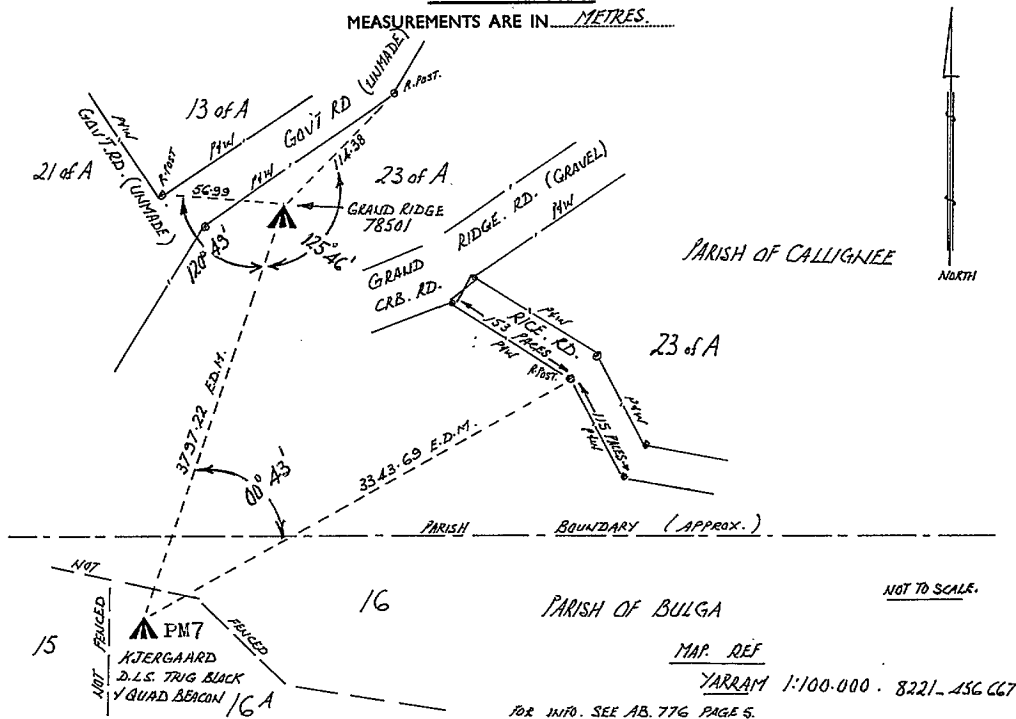

Established in connection with \* SECONDARY TRIANGULATION Ref. No. KJERGAARD  
 \*Type of Survey of Works

IF LEVELLED:—  
 Reduced level of Mark \_\_\_\_\_ to Datum †  
 † e.g., Railways, Board of Works, Sewerage Authority, etc., or Arbitrary

I certify that the Permanent Marks shown in this sketch have been established on the ground by me in accordance with the Regulations under the Survey Co-ordination Act 1958 and that the information shown hereon is correct.

Department of Authority CROWN LANDS & SURVEY Signature [Signature] †  
 Date 12.7.78.

‡ If a Licensed Surveyor the Letters L.S. to be added  
 TO BE FILLED IN BY THE CENTRAL PLAN OFFICE

| Zone | Square | Subdivision | Same Datum R.L.     | Number   |
|------|--------|-------------|---------------------|----------|
|      |        |             | R.L.<br>Copied from | <b>7</b> |

Noted on Record Plan B.714 (B) M. 10/8/78. KJERGAARD TRIG.

T.O. S.R. & W.S.C. Geo.Sect. ✓ Shire of: ALBERTON.

31 JUL 1978