

<b>Nine figure</b>	220900510	<b>Status</b>	OK	<b>Type</b>	SCN (GDA), Adj. AHD		
<b>Easting</b>	325638.955	<b>Northing</b>	5815737.325	<b>AHD height</b>	56.659	<b>Zone</b>	55
<b>Latitude</b>	-37° 47' 20.7715"	<b>Longitude</b>	145° 01' 11.3071"	<b>Ellipsoid height</b>	61.610	<b>CSF</b>	0.9999656
<b>H<sub>z</sub> uncertainty</b>	0.002	<b>H<sub>z</sub> order</b>	3	<b>V<sub>t</sub> uncertainty</b>	0.015	<b>V<sub>t</sub> order</b>	3
<b>Plan ref</b>	SP 20329	<b>Datum</b>	GDA2020				

<b>Plan Ref.</b>	<b>Point No. or Name</b>	<b>450 11377</b>
<b>Municipality</b>	<b>Area</b>	
<b>Prob Error E. Co-ords N.</b>	<b>Comp. Ref.</b>	<b>Comp. Ident.</b>

SKETCH Measurements in Metres

SEE STUDLEY PARK  
TRIG

Information should be verified by telephoning Survey Information Centre

Nine figure	220900510	Status	OK	Type	SCN (GDA), Adj. AHD	
Easting	325638.955	Northing	5815737.325	AHD height	56.659	Zone 55
Latitude	-37° 47' 20.7715"	Longitude	145° 01' 11.3071"	Ellipsoid height	61.610	CSF 0.9999656
H <sub>z</sub> uncertainty	0.002	H <sub>z</sub> order	3	V <sub>t</sub> uncertainty	0.015	V <sub>t</sub> order 3
Plan ref	SP 20329	Datum	GDA2020			

City of Kew M.M.B.W. 4

SEC. 6 (1) (c) SURVEY CO-ORDINATION ACT 1940

**PERMANENT MARK SKETCH PLAN**

Township CITY KEW Parish BOROONDARA


NOTE :- Not necessarily to Scale

- (1) Measurements to be shown from the Permanent Mark to as many near-by survey marks, buildings, fence posts, hydrants, trees, &c., as practicable. Up to six such measurements are desirable.
- (2) Except where verified by a Licensed Surveyor in this survey, all boundaries in this sketch plan are to be shown by broken lines. The symbols for fences, buildings, &c., to be shown on the broken lines.
- (3) Description of Permanent Mark and, where possible, Crown Abuttals are to be shown.

MEASUREMENTS ARE IN LINKS

CO-ORDINATES:

E. 325 526  
N. 5 815 552

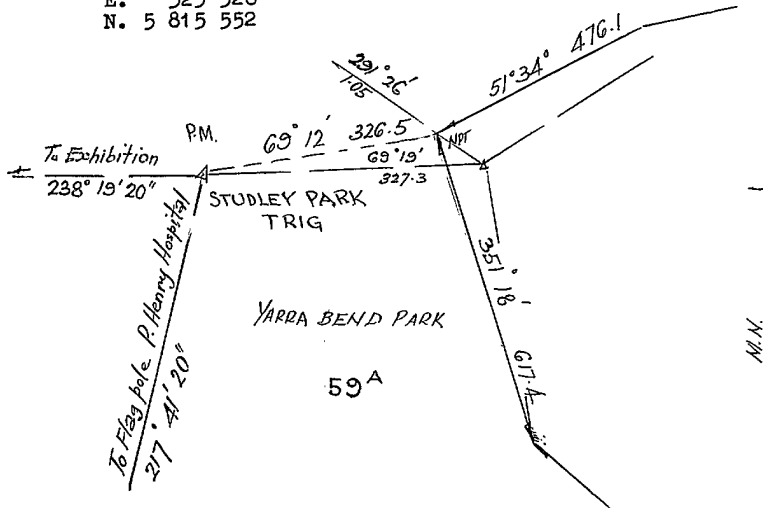

Established in connection with\* TITLE SURVEY Ref. No. R<sup>s</sup> 713A  
\*Type of Survey of Works.

IF LEVELLED :-  
Reduced level of Mark \_\_\_\_\_ to Datum † \_\_\_\_\_  
†e.g., Railways, Board of Works, Sewerage Authority, &c., or Arbitrary.

I certify that the Permanent Marks shown in this sketch have been established on the ground by me in accordance with the Regulations under the Survey Co-ordination Act 1940 and that the information shown hereon is correct.

Department or Authority LANDS & SURVEY Signature N.M. Robb L.S. †  
Date 3. 8. 59

TO BE FILLED IN BY THE CENTRAL PLAN OFFICE

X2626	X2626X	X2626X26	State Datum R.L.	Number
Surveys connected to this PM: SP. 14508 (CRB)			R.L.	51
			Copied from	

Noted on Record Plan B415 3. Fl. 11388 53 RD. 20.8.59  
A.11009/10.32-10015  
20 AUG 1959 MRI WBY.