

Nine figure	232200250	Status	OK	Type	SCN (GDA), Est. AHD
Easting	468427.101	Northing	5749145.789	AHD height	665.1 Zone 55
Latitude	-38° 24' 19.3027"	Longitude	146° 38' 18.2030"	Ellipsoid height	670.0 CSF 0.9995080
Hx uncertainty	0.028	Hx order	3	Vt uncertainty	Vt order 5
Plan ref		Datum	GDA2020		


SEC. 6 (1) (c) SURVEY CO-ORDINATION ACT 1958
PERMANENT MARK SKETCH PLAN

5

Township _____ Parish CALLIGNEE

NOTE:— Not necessarily to Scale
 (1) Measurements to be shown from the Permanent Mark to as many near-by survey marks, buildings, fence posts, hydrants, trees, etc., as practicable. Up to six such measurements are desirable.
 (2) Except where verified by a Licensed Surveyor in this survey, all boundaries in this sketch plan are to be shown by broken lines. The symbols for fences, buildings, etc., to be shown on the broken lines.
 (3) Description of Permanent Mark and, where possible, Crown Abutments are to be shown.

MEASUREMENTS ARE IN METRES

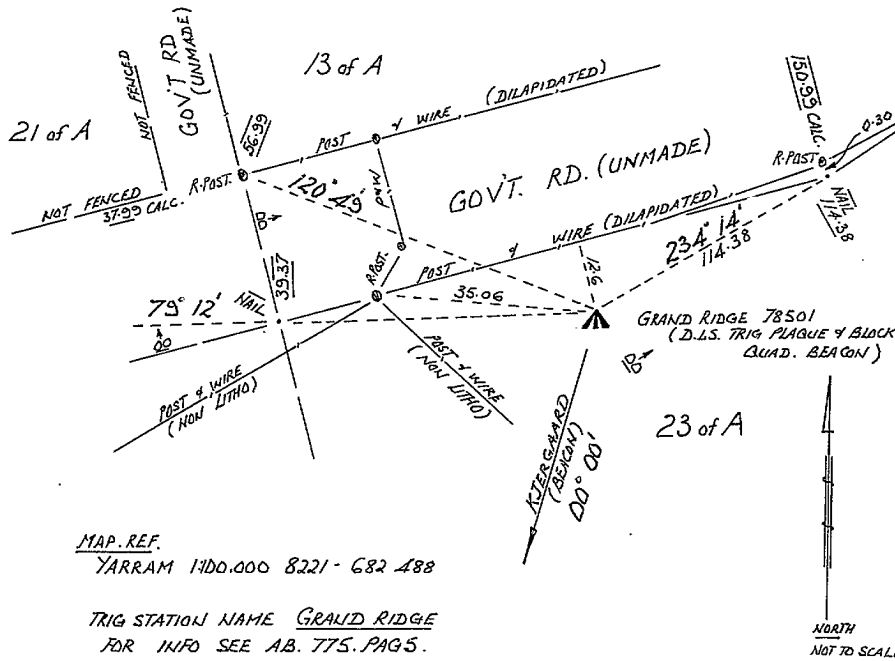

Established in connection with * YARRAM-STRADBROKE S.T. 53 Ref. No. 78501
 *Type of Survey of Works

IF LEVELLED:—
 Reduced level of Mark _____ to Datum †
 †e.g., Railways, Board of Works, Sewerage Authority, etc., or Arbitrary

I certify that the Permanent Marks shown in this sketch have been established on the ground by me in accordance with the Regulations under the Survey Co-ordination Act 1958 and that the information shown hereon is correct.

Department of Authority CROWN LANDS & SURVEY Signature [Signature] †
 Date 12.7.78.

† If a Licensed Surveyor the Letters L.S. to be added

TO BE FILLED IN BY THE CENTRAL PLAN OFFICE

Zone	Square	Subdivision	Same Datum R.L.	Number
			R.L. Copied from	25

Noted on Record Plan C.493(9) W/16.8.78. GRAND RIDGE TRIG. 78501

T.O. S.R. & W S.C. 2 S.E.C. Geo.Sec. Shire of: ALBERTON.

31 JUL 1978