


Nine figure	254801480	Status	OK	Type	SCN (GDA), AHD		
Easting	395362.586	Northing	5784264.704	AHD height	57.106	Zone	55
Latitude	-38° 05' 00.0695"	Longitude	145° 48' 24.7060"	Ellipsoid height	62.689	CSF	0.9997259
Hx uncertainty	0.032	Hx order	3	Vt uncertainty		Vt order	3
Plan ref		Datum	GDA2020				

SEC. 6 (1) (c) SURVEY CO-ORDINATION ACT 1958
PERMANENT MARK SKETCH PLAN

Township _____ Parish of Drouin West 173

- NOTE:— Not necessarily to Scale
- (1) Measurements to be shown from the Permanent Mark to as many near-by survey marks, buildings, fence posts, hydrants, trees, &c., as practicable. Up to six such measurements are desirable.
 - (2) Except where verified by a Licenced Surveyor in this survey, all boundaries in this sketch plan are to be shown by broken lines. The symbols for fences, buildings, &c., to be shown on the broken lines.
 - (3) Description of Permanent Mark and, where possible, Crown Abuttals are to be shown.

MEASUREMENTS ARE IN LINKS _____

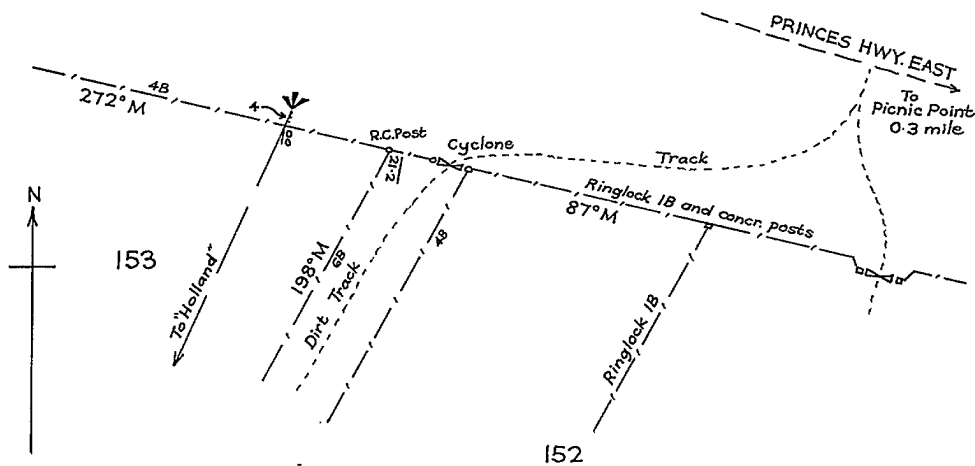

Established in connection with* Robin Hood Project (C.R.B.) Geodetic Control Ref. No. "PICNIC POINT"
 *Type of Survey of Works Trig.

IF LEVELLED:—
 Reduced level of Mark _____ to Datum † _____
 †e.g., Railways, Board of Works, Sewerage Authority, &c., or Arbitrary.

I certify that the Permanent Marks shown in this sketch have been established on the ground by me in accordance with the Regulations under the Survey Co-ordination Act 1958 and that the information shown hereon is correct.

Department or Authority of Crown Lands & Survey Signature S.P. Eccleston L.S. †
 Date 6:12:68

†If a Licensed Surveyor the letters L.S. to be added

TO BE FILLED IN BY THE CENTRAL PLAN OFFICE

XXXX	XXXXX	XXXXXXXX	Same Datum R.L.	Number
Title Surveys connected to this P.M.:			R.L.	148
LP.96295	SP 16783		Copied from	

Noted on Record Plan D.173 (15) 1-6-72 **PICNIC POINT TRIG.**

3927/67

16 DEC 1968

T.O. Shire of Buln Buln S.R. & W.S.C. Geo.Sect.