

Nine figure	264501000	Status	OK	Type	SCN (GDA), Est. AHD		
Easting	370269.849	Northing	5795841.088	AHD height	287.2	Zone	55
Latitude	-37° 58' 32.8746"	Longitude	145° 31' 22.4980"	Ellipsoid height	292.8	CSF	0.9997622
H <sub>z</sub> uncertainty	0.006	H <sub>z</sub> order	3	V <sub>t</sub> uncertainty		V <sub>t</sub> order	5
Plan ref		Datum	GDA2020				


SEC. 6 (1) (c) SURVEY CO-ORDINATION ACT 1958

PERMANENT MARK SKETCH PLAN 5

Township \_\_\_\_\_ Parish GEMBROOK

NOTE:— Not necessarily to Scale

- (1) Measurements to be shown from the Permanent Mark to as many near-by survey marks, buildings, fence posts, hydrants, trees, &c., as practicable. Up to six such measurements are desirable.
- (2) Except where verified by a Licensed Surveyor in this survey, all boundaries in this sketch plan are to be shown by broken lines. The symbols for fences, buildings, &c., to be shown on the broken lines.
- (3) Description of Permanent Mark and, where possible, Crown Abuttals are to be shown.

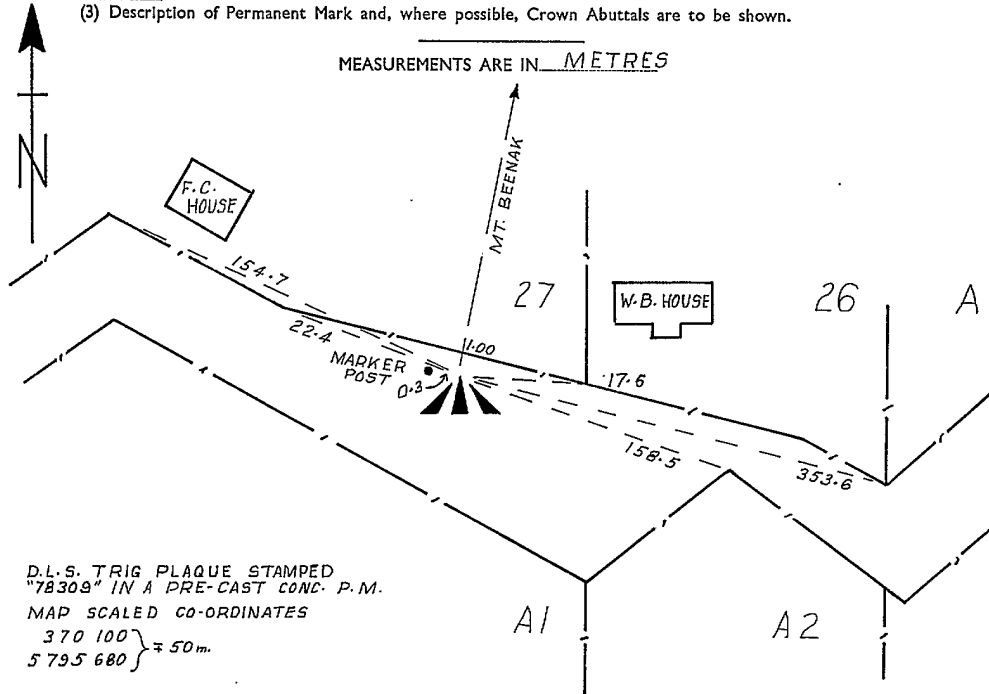

D.L.S. TRIG PLAQUE STAMPED  
"78309" IN A PRE-CAST CONC. P.M.  
MAP SCALED CO-ORDINATES  
370 100 } ± 50m.  
5795 680 }

Established in connection with\* GEODETIC CASSITERITE Trig.  
Ref. No. 78309

IF LEVELLED:— \*Type of Survey of Works  
Reduced level of Mark \_\_\_\_\_ to Datum † \_\_\_\_\_  
†e.g., Railways, Board of Works, Sewerage Authority, &c., or Arbitrary.

I certify that the Permanent Marks shown in this sketch have been established on the ground by me in accordance with the Regulations under the Survey Co-ordination Act 1958 and that the information shown hereon is correct.

Department of Authority CROWN LANDS & SURVEY Signature R. A. Donellan †  
Date 1-8-78

†If a Licensed Surveyor the letters L.S. to be added

TO BE FILLED IN BY THE CENTRAL PLAN OFFICE

Zone	Square	Subdivision	Same Datum R.L.	Number
SURVEYS CONNECTED TO THIS P.M.			R.L.	100
SP17469-71			Copied from	

Noted on Record Plan G-206<sup>(14)</sup> P.K. 22.9.78  
6173167

CASSITERITE TRIG.  
78309

7 AUG 1978

T.O. S.R. & W.S.C. M.M.B.W. D.V.A. Shire of: PAKENHAM  
Geo.Sec. ✓