



Nine figure	292000730	Status	OK	Type	SCN (GDA), Adj. AHD
Easting	363089.893	Northing	5769695.257	AHD height	5.448 Zone 55
Latitude	-38° 12' 37.0873"	Longitude	145° 26' 10.2530"	Ellipsoid height	9.718 CSF 0.9998300
H <sub>z</sub> uncertainty	0.003	H <sub>z</sub> order	3	V <sub>t</sub> uncertainty	0.016 V <sub>t</sub> order 3
Plan ref	SP22355	Datum	GDA2020		

128


5.

SEC. 6 (1) (c) SURVEY CO-ORDINATION ACT 1958

PERMANENT MARK SKETCH PLAN

Township..... Parish KOO-WEE-RUP

- NOTE:— Not necessarily to Scale
- Measurements to be shown from the Permanent Mark to as many near-by survey marks, buildings, fence posts, hydrants, trees, etc., as practicable. Up to six such measurements are desirable.
  - Except where verified by a Licensed Surveyor in this survey, all boundaries in this sketch plan are to be shown by broken lines. The symbols for fences, buildings, etc., to be shown on the broken lines.
  - Description of Permanent Mark and, where possible, Crown Abuttals are to be shown.

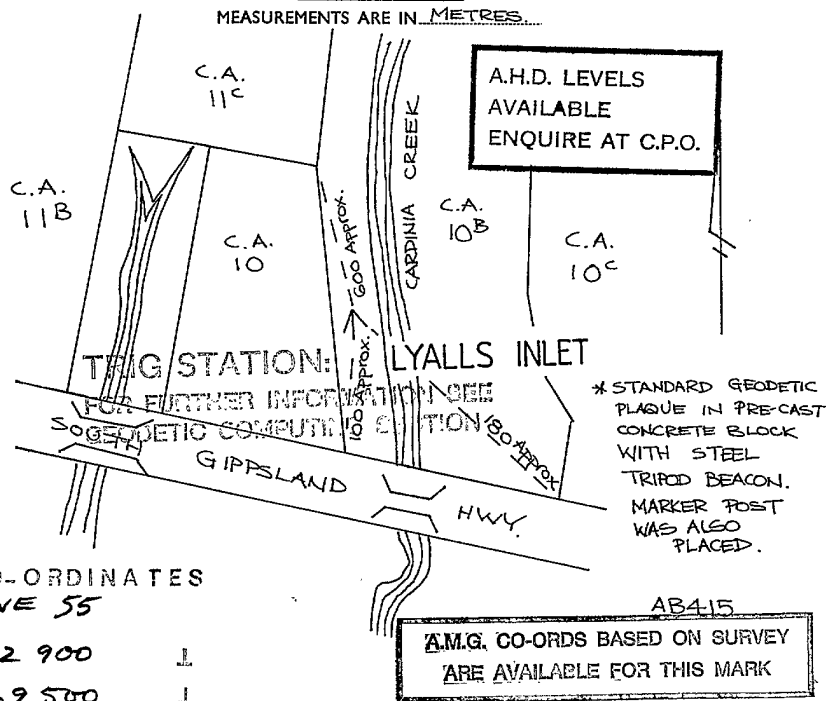

AMG CO-ORDINATES ZONE 55

E 362 900 L  
N 5769 500 L

Established in connection with \* GEODETIC SURVEY Ref. No. ....  
\*Type of Survey of Works

IF LEVELLED:—  
Reduced level of Mark..... to Datum †  
†e.g., Railways, Board of Works, Sewerage Authority, etc., or Arbitrary

I certify that the Permanent Marks shown in this sketch have been established on the ground by me in accordance with the Regulations under the Survey Co-ordination Act 1958 and that the information shown hereon is correct.

Department or Authority DIVISION OF SURVEY & MAPPING Signature GEODETIC COMP  
Date 1 APRIL 1982

‡ If a Licensed Surveyor the Letters L.S. to be added

TO BE FILLED IN BY THE CENTRAL PLAN OFFICE

Zone XXXX	Square XXXXXX	Subdivision XXXXXXX	Same Datum R.L.	Number <u>73</u>
Surveys connected to this Plan P 16625-9			R.L. Copied from	LYALLS INLET TRIG <b>73</b>

Noted on Record Plan 1:10,000 ARRUM 7.2 P.S 6-9-85-  
T.O R.W.C D.V.A Geod Comp Shire of CRANBOURNE

16 MAY 1982