

Nine figure	313501810	Status	OK	Type	SCN (GDA), Est. AHD
Easting	432348.807	Northing	5769429.364	AHD height	404.90 Zone 55
Latitude	-38° 13' 14.0571"	Longitude	146° 13' 37.7284"	Ellipsoid height	410.66 CSF 0.9995929
H _z uncertainty	0.012	H _z order	3	V _t uncertainty	V _t order
Plan ref		Datum	GDA2020		


ARE AVAILABLE FOR THIS MARK
 M.A.M.G. CO-ORDS BASED ON SURVEY
 SEC. 6 (1) (c) SURVEY CO-ORDINATION ACT 1958

PERMANENT MARK SKETCH PLAN

3

Township..... Parish **MOE**

- NOTE:— Not necessarily to Scale
- (1) Measurements to be shown from the Permanent Mark to as many near-by survey marks, buildings, fence posts, hydrants, trees, etc., as practicable. Up to six such measurements are desirable.
 - (2) Except where verified by a Licensed Surveyor in this survey, all boundaries in this sketch plan are to be shown by broken lines. The symbols for fences, buildings, etc., to be shown on the broken lines.
 - (3) Description of Permanent Mark and, where possible, Crown Abuttals are to be shown.

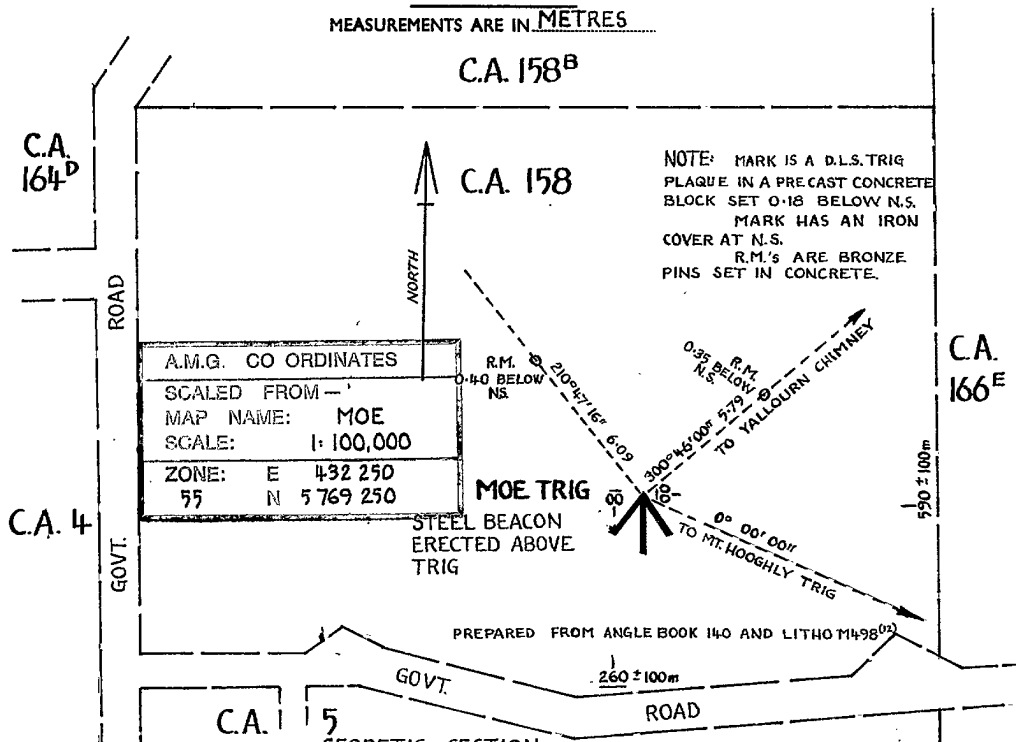

Established in connection with * **GEODETIC SECTION** Ref. No. **A.B. 140**
 *Type of Survey of Works **MOE TRIG**

IF LEVELLED:— Reduced level of Mark _____ to Datum _____
 (e.g., Railways, Board of Works, Sewerage Authority, etc., or Arbitrary)

I certify that the Permanent Marks shown in this sketch have been established on the ground by me in accordance with the Regulations under the Survey Co-ordination Act 1958 and that the information shown hereon is correct.

Department or Authority **CROWN LANDS & SURVEY** Signature **J.M. B...**
 Date **29.02.1980**

† If a Licensed Surveyor the Letters L.S. to be added

TO BE FILLED IN BY THE CENTRAL PLAN OFFICE

Zone	Square	Subdivision	Same Datum R.L.	Number
			R.L. Copied from	181

Noted on Record Plan **MA 99 (13) CH 9.6.80** MOE TRIG. AB.40

T.O. Shire of Narracan S.R. & W.S.C. Geo.Sec. ✓

23 MAY 1980