

Nine figure	327900010	Status	OK	Type	SCN (GDA), Est. AHD		
Easting	360899.123	Northing	5802753.414	AHD height	419.6	Zone	55
Latitude	-37° 54' 43.6812"	Longitude	145° 25' 03.3430"	Ellipsoid height	425.1	CSF	0.9997725
H <sub>z</sub> uncertainty	0.013	H <sub>z</sub> order	3	V <sub>t</sub> uncertainty		V <sub>t</sub> order	5
Plan ref		Datum	GDA2020				

Plan Ref.	Point No. or Name		450 11333
Municipality		Area	
Prob Error E. Co-ords N.	Comp. Ref.	Comp. Ident.	

SKETCH Measurements in Metres

SEE JOHNS HILL & J H SOUTH  
TRIG

Information should be verified by telephoning Survey Information Centre

Nine figure	327900010	Status	OK	Type	SCN (GDA), Est. AHD
Easting	360899.123	Northing	5802753.414	AHD height	419.6 Zone 55
Latitude	-37° 54' 43.6812"	Longitude	145° 25' 03.3430"	Ellipsoid height	425.1 CSF 0.9997725
H <sub>z</sub> uncertainty	0.013	H <sub>z</sub> order	3	V <sub>t</sub> uncertainty	V <sub>t</sub> order 5
Plan ref		Datum	GDA2020		


SEC. 6 (1) (c) SURVEY CO-ORDINATION ACT 1940  
**PERMANENT MARK SKETCH PLAN**

Township \_\_\_\_\_ Parish Narree Worrان

NOTE :- Not necessarily to Scale

(1) Measurements to be shown from the Permanent Mark to as many near-by survey marks, buildings, fence posts, hydrants, trees, &c., as practicable. Up to six such measurements are desirable.

(2) Except where verified by a Licensed Surveyor in this survey, all boundaries in this sketch plan are to be shown by broken lines. The symbols for fences, buildings, &c., to be shown on the broken lines.

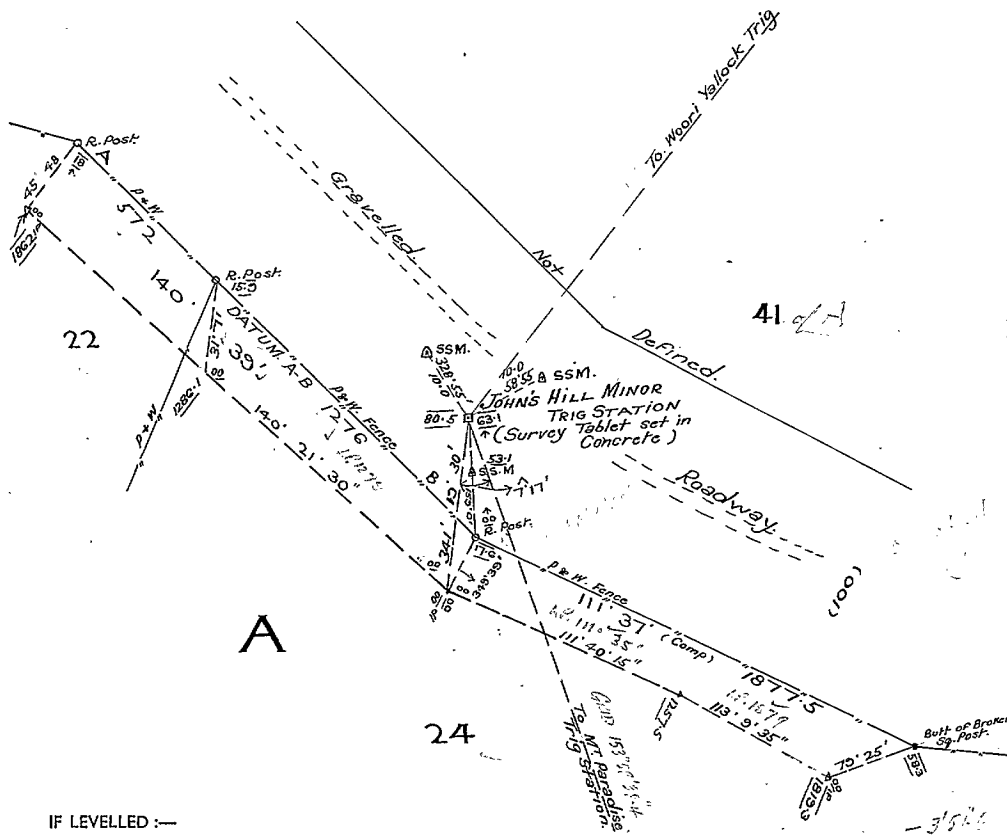

IF LEVELLED :-  
 Reduced level of Mark \_\_\_\_\_ to Datum \*  
 \* e.g., Railways, Board of Works, Sewerage Authority, &c., or Arbitrary.

I certify that the permanent marks shown in this sketch have been established on the ground by me in accordance with the regulations under the Survey Co-ordination Act 1940 and that the information shown hereon is correct.

Department or Authority Lands & Survey Signature H. Macey L.S. †  
 Date 16. 2. 45.

† If a Licensed Surveyor the letters L.S. to be added.  
 TO BE FILLED IN BY THE CENTRAL PLAN OFFICE

XXXXX	XXXXXX	XXXXXXXXXX	State Datum R.L.	Number
Surveys connected to this P.M.			R.L.	<b>/</b>
SP 16630			from Central Plan	
			No.	

Recorded on Record Plan N 19 (6) E.S.M. 18. 4. 45.  
 A.1327/8.41-9112. M49  
 JOHN'S HILL MINOR TRIG.