

Nine figure	354300300	Status	OK	Type	Non-SCN (GDA), Est. AHD	
Easting	446038.63	Northing	5779340.03	AHD height	275.93	Zone 55
Latitude	-38° 07' 55.851"	Longitude	146° 23' 03.419"	Ellipsoid height	CSF	0.9995926
H _z uncertainty		H _z order	4	V _t uncertainty	V _t order	4
Plan ref		Datum	GDA2020			


Shire of Narracan (2 S.E.C.) Forest 6

SEC. 6 (1) (c) SURVEY CO-ORDINATION ACT 1940
PERMANENT MARK SKETCH PLAN

Township _____ Parish TANJIL EAST

- NOTE :- Not necessarily to Scale
- (1) Measurements to be shown from the Permanent Mark to as many near-by survey marks, buildings, fence posts, hydrants, trees, &c., as practicable. Up to six such measurements are desirable.
 - (2) Except where verified by a Licensed Surveyor in this survey, all boundaries in this sketch plan are to be shown by broken lines. The symbols for fences, buildings, &c., to be shown on the broken lines.
 - (3) Description of Permanent Mark and, where possible, Crown Abuttals are to be shown.

MEASUREMENTS ARE IN FEET

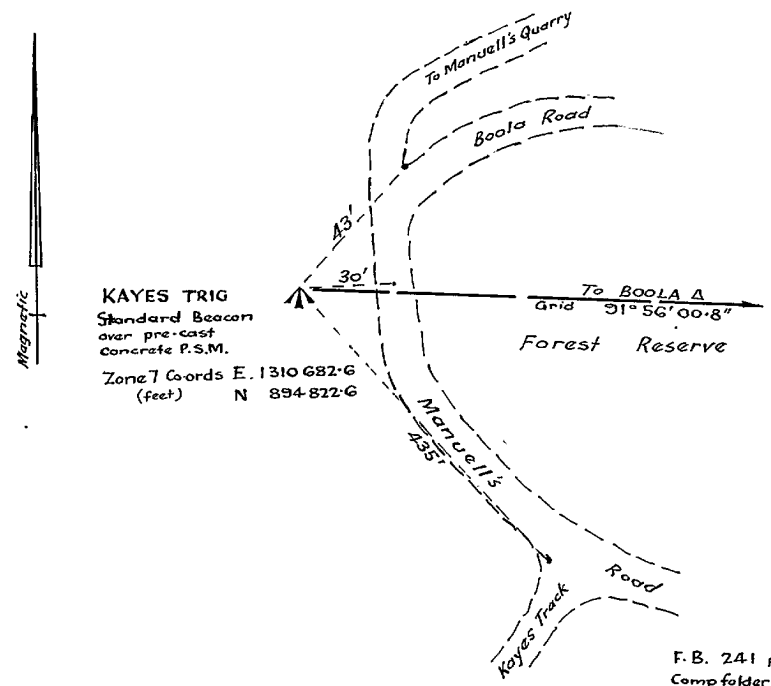

F. B. 241 p. 33
 Comp folder 2-2-23

Established in connection with* Crown Grant Survey Ref. No. Kayes A
*Type of Survey of Works.

IF LEVELLED :- Reduced level of Mark _____ to Datum † _____
†e.g., Railways, Board of Works, Sewerage Authority, &c., or Arbitrary.

I certify that the Permanent Marks shown in this sketch have been established on the ground by me in accordance with the Regulations under the Survey Co-ordination Act 1940 and that the information shown hereon is correct.

Department or Authority State Electricity Commission of Victoria Signature L. E. Howard's †
 Date 22-10-58

TO BE FILLED IN BY THE CENTRAL PLAN OFFICE

Zone	Square	Subdivision	State Datum R.L.	Number
			R.L.	30 KAYES TRIG.
			Copied from	

Noted on Record Plan T10014 R/L 16.3.52 SEE ALSO adjacent mark TANJIL EAST 35.
A.1509/10.02-11015

26 MAR 1959