


Nine figure	314600020	Status	OK	Type	SCN (GDA), AHD
Easting	355127.678	Northing	5808048.833	AHD height	470.747
Latitude	-37° 51' 48.6883"	Longitude	145° 21' 10.8988"	Ellipsoid height	476.330
H _z uncertainty	0.003	H _z order	3	V _t uncertainty	Zone 55
Plan ref		Datum	GDA2020		CSF 0.9997847
					V _t order 3

Plan Ref.	YARRA 6-2	Point No. or Name	MMB 3254
Municipality	SHERBROOKE	Area	E
Prob Error E. Co-ords	N.	Comp. Ref.	Comp. Ident.

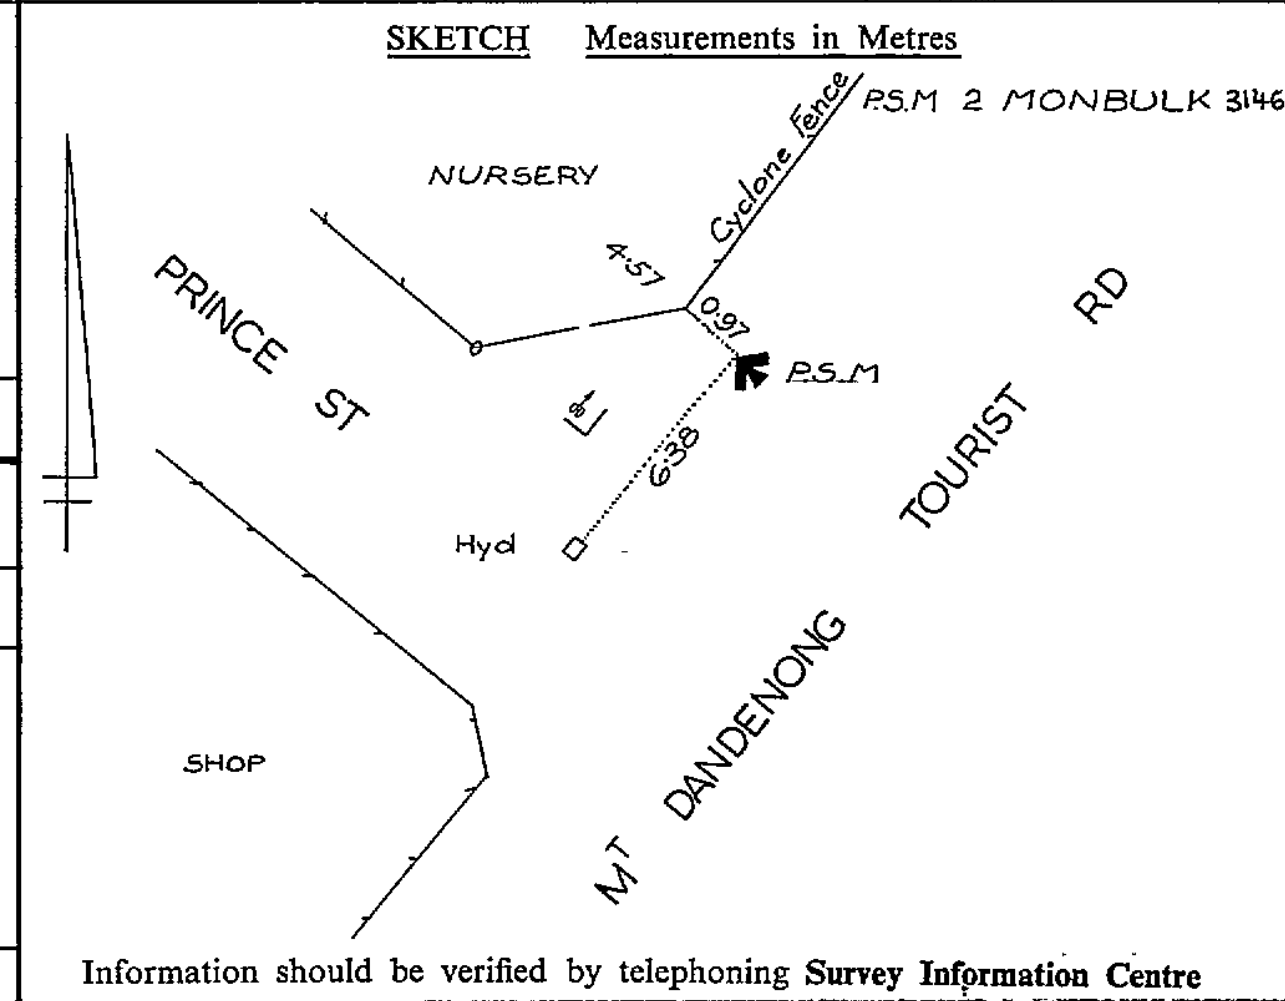

Nine figure	314600020	Status	OK	Type	SCN (GDA), AHD		
Easting	355127.678	Northing	5808048.833	AHD height	470.747	Zone	55
Latitude	-37° 51' 48.6883"	Longitude	145° 21' 10.8988"	Ellipsoid height	476.330	CSF	0.9997847
Hx uncertainty	0.003	Hx order	3	Vt uncertainty		Vt order	3
Plan ref		Datum	GDA2020				


SEC. 6 (1) (c) SURVEY CO-ORDINATION ACT 1940

PERMANENT MARK SKETCH PLAN

Township ~~WASSA WASSA~~ Parish MONBULK

NOTE :- Not necessarily to Scale

- (1) Measurements to be shown from the Permanent Mark to as many near-by survey marks, buildings, fence posts, hydrants, trees, &c., as practicable. Up to six such measurements are desirable.
- (2) Except where verified by a Licensed Surveyor in this survey, all boundaries in this sketch plan are to be shown by broken lines. The symbols for fences, buildings, &c., to be shown on the broken lines.
- (3) Description of Permanent Mark and, where possible, Crown Abuttals are to be shown.

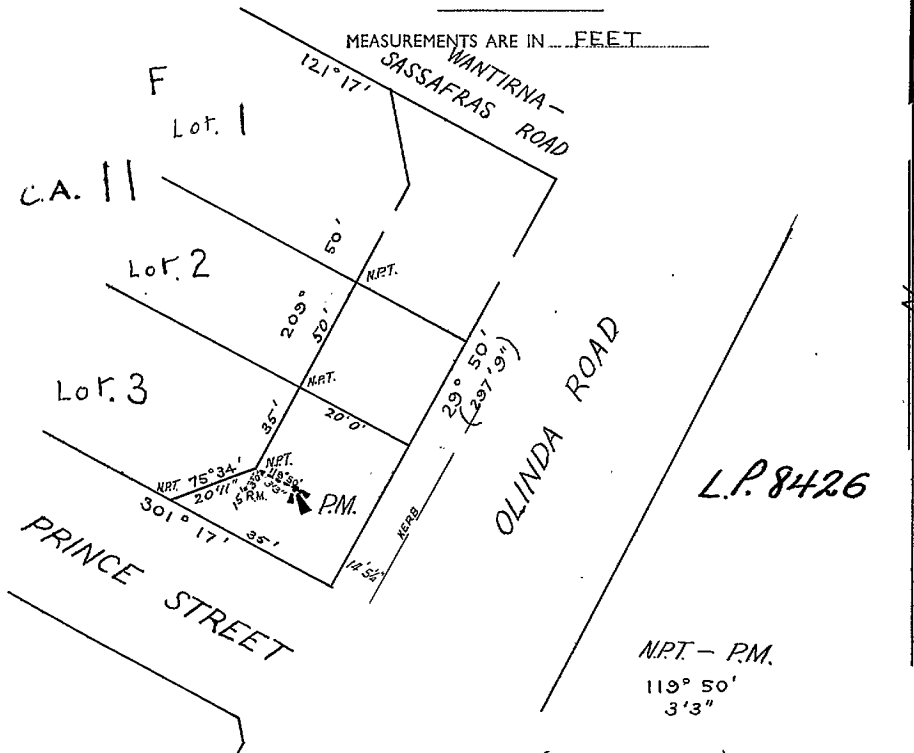

Established in connection with* ROAD WIDENING (TITLE SURVEY) Ref. No. SP 6780

IF LEVELLED :- Reduced level of Mark _____ to Datum † _____
† e.g., Railways, Board of Works, Sewerage Authority, &c., or Arbitrary.

I certify that the Permanent Marks shown in this sketch have been established on the ground by me in accordance with the Regulations under the Survey Co-ordination Act 1940 and that the information shown hereon is correct.

Department or Authority COUNTRY ROADS BOARD Signature J.S. Smallman
 Date 13. 2. 58

TO BE FILLED IN BY THE CENTRAL PLAN OFFICE

ZONE	SQUARE	SUBDIVISION	State Datum R.L.	Number
Surveys connected to this Plan			R.L.	
OP. 103819			Copied from	2

Noted on Record Plan M 555 14. 7. 58 38, 12. 9. 73, 24 MY
A.1000/10.62.-10015
17 FEB 1958 C.R.B. FERNTREE GULLY. MBS 555